

STATE ENGINEER
Salem, Oregon

LINN
4524

Well Record

STATE WELL NO. 10/3W-5H(1)
COUNTY Linn
APPLICATION NO. GR-173

OWNER: Myron & Ballard Ingraham


MAILING ADDRESS: Rt. 2, Box 362

LOCATION OF WELL: Owner's No. 2

CITY AND STATE: Albany, Oregon

SE 1/4 NE 1/4 Sec. 5 T. 10 N. S., R. 3 W., W.M.

Bearing and distance from section or subdivision corner N. 31 1/2° W. 16.5 chs. from SE cor. SE 1/4 Sec. 5

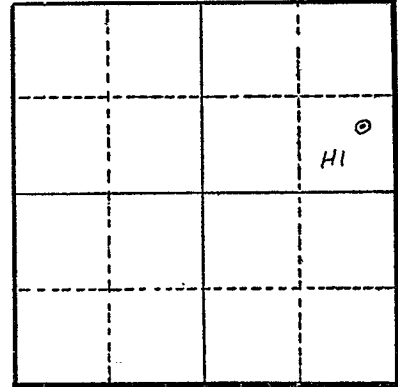

Section 5

Altitude at well 185 ft. Interpolated

TYPE OF WELL: drilled Date Constructed 4/16/51

Depth drilled 25 ft. Depth cased

CASING RECORD: 8 - inch steel casing set from 0 to 25 ft.

FINISH: Slit perforations from 15 to 25 ft.

AQUIFERS: unknown

WATER LEVEL: unknown

PUMPING EQUIPMENT: Type 2" Fairbanks Morse centrifugal H.P. 10
Capacity 250 G.P.M.

WELL TESTS:
Drawdown 2 ft. after hours pumping 400 G.P.M.
Drawdown ft. after hours G.P.M.

USE OF WATER irrigation 20.7 acres Temp. °F., 19
SOURCE OF INFORMATION Reg. St. GR-173

DRILLER or DIGGER
ADDITIONAL DATA:
Log Water Level Measurements Chemical Analysis Aquifer Test

REMARKS: