

STATE ENGINEER
Salem, Oregon

LINN
4534

Well Record

STATE WELL NO. 10/3W-5N(1)
COUNTY Linn
APPLICATION NO. GR-317

OWNER: Elbert H. & Esther F. Chambers
MAILING ADDRESS: Rt. 2, Box 341

LOCATION OF WELL: Owner's No. 8
CITY AND STATE: Albany, Oregon


SW 1/4 SW 1/4 Sec. 5 T. 10 N. S., R. 3 E. W., W.M.

Bearing and distance from section or subdivision
corner N. 49°03' E. 14.43 chs. from SW cor. Sec. 5

Altitude at well 185 ft. Interpolated

TYPE OF WELL: drilled Date Constructed 6/5/51

Depth drilled 30 ft. Depth cased 30 ft.

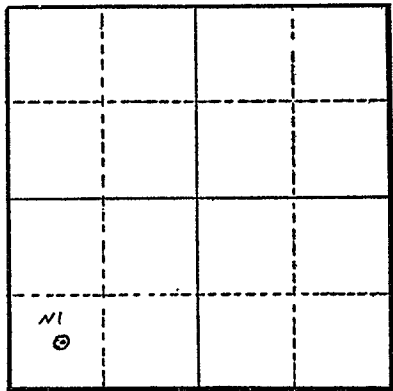

Section 5

CASING RECORD: 10 - inch casing set from 0 to 30 ft.

FINISH: slots set from 24 to 30 ft.

AQUIFERS: unknown

WATER LEVEL: 9 ft. below land surface

PUMPING EQUIPMENT: Type Fairbanks Morse 3" centrifugal H.P. 15
Capacity 350 G.P.M.

WELL TESTS:
Drawdown 12 ft. after _____ hours pumping 400 G.P.M.
Drawdown _____ ft. after _____ hours _____ G.P.M.

USE OF WATER irrigation 33.0 acres Temp. _____ °F. _____, 19

SOURCE OF INFORMATION Reg. St. GR-317

DRILLER or DIGGER Bill Hamilton; Albany, Oregon

ADDITIONAL DATA:
Log _____ Water Level Measurements _____ Chemical Analysis _____ Aquifer Test _____

REMARKS: