

STATE ENGINEER
Salem, Oregon

LINN
4535

Well Record


STATE WELL NO. 10/3W-6G
COUNTY Linn
APPLICATION NO. GR-3027

OWNER: Howard J. and Doris E. Snodgrass
MAILING ADDRESS: Route 2, Box 355

LOCATION OF WELL: Owner's No. 1
CITY AND STATE: Albany, Oregon

SW 1/4 NE 1/4 Sec. 6 T. 10 S., R. 3 W., W.M.

Bearing and distance from section or subdivision
corner N. 61° 50' W. 25.2 chains from S.E.
corner of NE 1/4

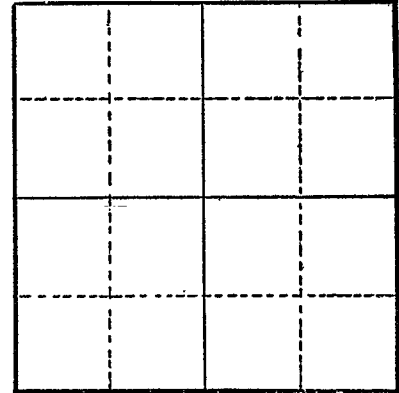

Section

Altitude at well

TYPE OF WELL: drilled Date Constructed 1945

Depth drilled 21 Depth cased 18

CASING RECORD:
12 inches, steel casing

FINISH:
Slot perforations from 8 to 18

AQUIFERS:

WATER LEVEL:

PUMPING EQUIPMENT: Type Fairbanks Morse Centrifugal H.P. 10
Capacity G.P.M.

WELL TESTS:
Drawdown ft. after hours G.P.M.
Drawdown ft. after hours G.P.M.

USE OF WATER Irrigation Temp. °F., 19

SOURCE OF INFORMATION GR-2835

DRILLER or DIGGER Mr. Wymore, Salem

ADDITIONAL DATA:
Log Water Level Measurements Chemical Analysis Aquifer Test

REMARKS: