

STATE ENGINEER
Salem, Oregon

LINN
4536

Well Record

STATE WELL NO. 10/3W-6H(2)
COUNTY Linn
APPLICATION NO. GR-772

OWNER: Ardle Edwards


MAILING ADDRESS: Rt. 2, Box 350

LOCATION OF WELL: Owner's No. 1

CITY AND STATE: Albany, Oregon

SE 1/4 NE 1/4 Sec. 6 T. 10 N. S. R. 3 E. W., W.M.

Bearing and distance from section or subdivision corner 1825' S. & 20' W. of NE cor. Sec. 6

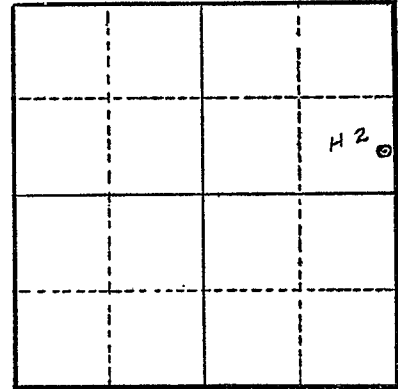

Altitude at well 180 ft. Interpolated

Section 6

TYPE OF WELL: drilled Date Constructed April 1948

Depth drilled 22 ft. Depth cased 22 ft.

CASING RECORD: 8 inch

FINISH:

AQUIFERS:

WATER LEVEL: 8 ft.

PUMPING EQUIPMENT: Type Fairbanks Morse electric centrifugal H.P. 10
Capacity G.P.M.

WELL TESTS:
Drawdown ft. after hours G.P.M.
Drawdown ft. after hours G.P.M.

USE OF WATER irrigation Temp. °F. 19

SOURCE OF INFORMATION GR-772

DRILLER or DIGGER

ADDITIONAL DATA:

Log ^X Water Level Measurements Chemical Analysis Aquifer Test

REMARKS: Log: Sandy loam 0 to 6
Gravel ?