

STATE ENGINEER  
Salem, Oregon

LINN  
4537


Well Record

STATE WELL NO. 10/3W-6H(1)  
COUNTY Linn  
APPLICATION NO.

OWNER: Chester F. & Hazel M. Royer  
MAILING ADDRESS: Rt. 2, Box 351

LOCATION OF WELL: Owner's No. 2  
CITY AND STATE: Albany, Oregon

SE 1/4 NE 1/4 Sec. 6 T. 10 N. S. R. 3 E. W., W.M.  
Bearing and distance from section or subdivision  
corner N. 33° E. 14.75 chs. from NW cor. of  
Samuel T. Jones DLC 73

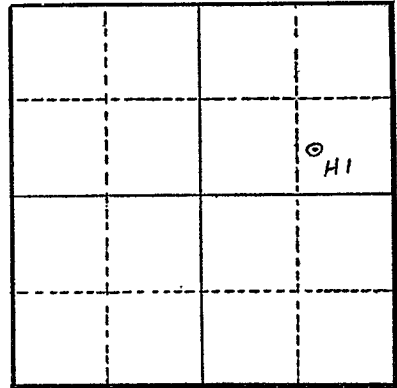

Section 6

Altitude at well 180 ft.

TYPE OF WELL: drilled Date Constructed 1944  
Depth drilled 20 ft. Depth cased 20 ft.

CASING RECORD: 12 inch

FINISH:

AQUIFERS:

WATER LEVEL: 8 ft.

PUMPING EQUIPMENT: Type centrifugal H.P. 15  
Capacity 400 G.P.M.

WELL TESTS:  
Drawdown ft. after hours G.P.M.  
Drawdown ft. after hours G.P.M.

USE OF WATER irrigation 24.4 acres Temp. °F. 19

SOURCE OF INFORMATION  
DRILLER or DIGGER  
ADDITIONAL DATA:

Log Water Level Measurements Chemical Analysis Aquifer Test

REMARKS:



Oregon Water Resources Department
725 Summer Street NE, Suite A
Salem Oregon 97301
(503) 986-0900
www.wrd.state.or.us

Application for
Well ID Number

Do not complete if the well already has a Well Identification Number.

I. OWNER INFORMATION

Current Owner Name (please print): Douglas and Kari Burton
Mailing Address: 32619 Cooper Dr. NE RECEIVED BY OWRD
City, State, Zip: Albany, OR 97321 DEC 15 2017
Mail Well ID Tag to: [X] SAME AS ABOVE [ ] In Care Of (C/O)
Name & Address: SALEM, OR
City, State, Zip:

II. WELL LOCATION INFORMATION (Please fill out as completely as possible)

Township: 10S (North / South) Range: 3W (East / West) Section: 6 SE 1/4 of the NE 1/4
Tax Lot (usually last 3-5 numbers of Tax Map #): 200 County Linn
GPS Coordinates:
Street Address of Well, City: 32619 Cooper Dr. NE, Albany OR
If the property had a different street address in the past:

III. GENERAL WELL INFORMATION (Please fill out as completely as possible, AND attach copy of Well Log, if available)

Use of Well (domestic, irrigation, commercial, industrial, monitoring): Irrigation
Date Well Constructed (or property built): 1944 Total Well Depth: 20 Casing Diameter: 12"
Owner at time the well was constructed (if known): Royer Well Log # (if known): GR-202
Other Information: L -> Linn 4537

SUBMITTED BY (please print): Doug Burton Po Box 165 Albany 97321
PHONE: 541-791-8758 EMAIL &/or FAX: doug@blueberrymile.com

Send application to: Oregon Water Resources Department 725 Summer St NE, Suite A, Salem, Oregon 97301; or fax to (503) 986-0902.
Applications are processed in the order they are received, and Well ID Numbers are mailed within 4-5 business days.

For Official Use Only by the Oregon Water Resources Department:
Received Date: 12-15-17 Well Log Number: LINN 4537 Well Identification #: L-128645