

STATE ENGINEER
Salem, Oregon

LINN
4538

Well Record

STATE WELL NO. 10/3W-6J(1)
COUNTY Linn
APPLICATION NO. GR-317

OWNER: Elbert H. & Esther F. Chambers
MAILING ADDRESS: Rt. 2, Box 341

LOCATION OF WELL: Owner's No. 10
CITY AND STATE: Albany, Oregon

NE 1/4 SE 1/4 Sec. 6 T. 10 S., R. 3 W., W.M.


Bearing and distance from section or subdivision corner S. 49° 22' E. 15.15 chs. from NW cor.

Samuel T. Jones DLC 73

Altitude at well 185 ft. Interpolated

TYPE OF WELL: drilled Date Constructed 1944

Depth drilled 30 ft. Depth cased 30 ft.

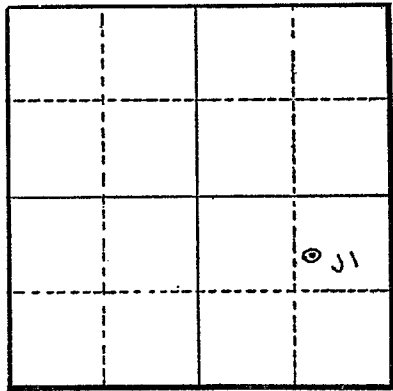

Section 6

CASING RECORD: 10 - inch steel casing set from 0 to 30 ft.

FINISH: Slots from 24 to 30 ft.

AQUIFERS: unknown

WATER LEVEL: 10 ft. below land surface

PUMPING EQUIPMENT: Type Allis Chalmers 3" centrifugal H.P. 15
Capacity 350 G.P.M.

WELL TESTS:
Drawdown 4 ft. after hours pumping 500 G.P.M.
Drawdown ft. after hours G.P.M.

USE OF WATER irrigation 42.3 acres Temp. °F. 19

SOURCE OF INFORMATION Reg. St. GR-317

DRILLER or DIGGER Wymore, Woodburn, Oregon

ADDITIONAL DATA:
Log Water Level Measurements Chemical Analysis Aquifer Test

REMARKS: