

STATE ENGINEER  
Salem, Oregon

LINN  
4539

# Well Record


STATE WELL NO. 10/3W-6K  
COUNTY Linn  
APPLICATION NO. GR-3031

OWNER: Howard J. and Doris E. Snodgrass MAILING ADDRESS: Route 2, Box 355

LOCATION OF WELL: Owner's No. 6 CITY AND STATE: Albany, Oregon

NW 1/4 SE 1/4 Sec. 6 T. 10 S., R. 3 W., W.M.

Bearing and distance from section or subdivision corner S. 69° 25' W. 38.2 chains from the N.E. corner of the SE 1/4

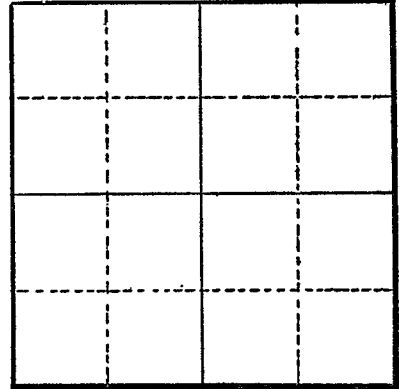

Section

Altitude at well

TYPE OF WELL: drilled Date Constructed 1950

Depth drilled 24 Depth cased

### CASING RECORD:

8 inch

### FINISH:

### AQUIFERS:

### WATER LEVEL:

PUMPING EQUIPMENT: Type Fairbanks Morse Centrifugal H.P. 10  
Capacity 250 G.P.M.

WELL TESTS:  
Drawdown ft. after hours G.P.M.  
Drawdown ft. after hours G.P.M.

USE OF WATER Irrigation Temp. °F., 19

SOURCE OF INFORMATION GR-2839

DRILLER or DIGGER

ADDITIONAL DATA:  
Log Water Level Measurements Chemical Analysis Aquifer Test

### REMARKS: