

STATE ENGINEER
Salem, Oregon

LINN
4540

Well Record

STATE WELL NO. 10/3W-6L(1)
COUNTY Linn
APPLICATION NO. GR-1020

GR- 985

OWNER: D. L. Cook


MAILING ADDRESS: Rt. 2, Box 337

LOCATION OF WELL: Owner's No. #2

CITY AND STATE: Albany, Oregon

NE 1/4 SW 1/4 Sec. 6 T. 10 S., R. 3 W., W.M.

Bearing and distance from section or subdivision corner S15°E. 14 ch. from the NW. cor. D13, #72.

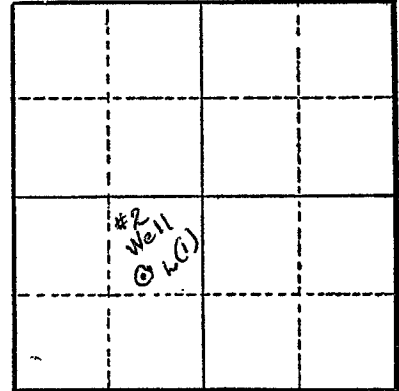

Section 6

Altitude at well 180 ft.

TYPE OF WELL: Drilled Date Constructed 1954

Depth drilled 36 ft. Depth cased 36 ft.

CASING RECORD:

12 ft.

FINISH:

AQUIFERS:

WATER LEVEL:

12 ft.

PUMPING EQUIPMENT: Type 3" Cent. H.P. 40

Capacity 400 G.P.M.

WELL TESTS:

Drawdown 10 ft. after 400 hours G.P.M.

Drawdown ft. after hours G.P.M.

USE OF WATER Irrigation Temp. °F. 19

SOURCE OF INFORMATION G.R. Record

DRILLER or DIGGER Bill Hamilton Drilling Co.

ADDITIONAL DATA:

Log N.A. Water Level Measurements Chemical Analysis Aquifer Test

REMARKS:

Irrigation of 7 acres.