

STATE ENGINEER  
Salem, Oregon

LINN  
4541

# Well Record

STATE WELL NO. 10/3W-6M(1)  
COUNTY Linn  
APPLICATION NO. GR-1019

GR- 984

OWNER: D. L. Cook


MAILING ADDRESS: Rt. 2, Box 337

LOCATION OF WELL: Owner's No. #1

CITY AND STATE: Albany, Oregon

NW 1/4 SW 1/4 Sec. 6 T. 10 S., R. 3 W., W.M.

Bearing and distance from section or subdivision corner S48°W. 14.75 ch. from NW cor. DIC #72

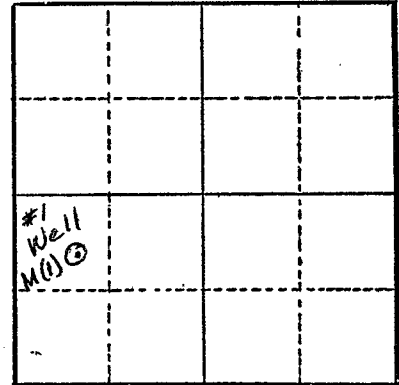

Altitude at well 180 ft.

TYPE OF WELL: Drilled Date Constructed 1948

Depth drilled 35 ft. Depth cased 35 ft.

Section 6

### CASING RECORD:

12 ft.

### FINISH:

### AQUIFERS:

### WATER LEVEL:

12 ft.

PUMPING EQUIPMENT: Type 4" Cent. H.P. 20

Capacity 475 G.P.M.

### WELL TESTS:

Drawdown 10 ft. after 500 hours G.P.M.

Drawdown ft. after hours G.P.M.

USE OF WATER Irrigation Temp. °F. 19

SOURCE OF INFORMATION G.R. Record

DRILLER or DIGGER Bill Hamilton Drilling Co.

### ADDITIONAL DATA:

Log N.A. Water Level Measurements Chemical Analysis Aquifer Test

### REMARKS:

Irrigation of 63.8 acres.