

STATE ENGINEER
Salem, Oregon

LINN
4542

Well Record

STATE WELL NO. 10/3W-6N(1)
COUNTY Linn
APPLICATION NO. GR-1021

GR- 986

OWNER: D. I. Cook


MAILING ADDRESS: Rt. 2, Box 337

LOCATION OF WELL: Owner's No. #3

CITY AND STATE: Albany, Oregon

SW 1/4 SW 1/4 Sec. 6 T. 10 S., R. 3 W., W.M.

Bearing and distance from section or subdivision corner S20°W. 32 ch. from NW cor. DIC #72.

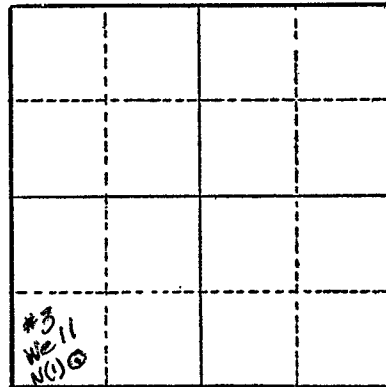

Section 6

Altitude at well 180 ft.

TYPE OF WELL: Drilled Date Constructed 1953

Depth drilled 36 ft. Depth cased 36 ft.

CASING RECORD:

10 inch

FINISH:

AQUIFERS:

WATER LEVEL:

12 ft.

PUMPING EQUIPMENT: Type 3" Cent. H.P. 15

Capacity 360 G.P.M.

WELL TESTS:

Drawdown 10 ft. after 400 hours G.P.M.

Drawdown ft. after hours G.P.M.

USE OF WATER Irrigation Temp. °F., 19

SOURCE OF INFORMATION G.R. Record

DRILLER or DIGGER

ADDITIONAL DATA:

Log N.A. Water Level Measurements Chemical Analysis Aquifer Test

REMARKS:

Irrigation of 33.7 acres.