

STATE ENGINEER  
Salem, Oregon

LINN  
4544

# Well Record

STATE WELL NO. 10/3W-6R(1)  
COUNTY Linn  
APPLICATION NO. GR-317


OWNER: Elbert H. & Esther F. Chambers  
MAILING ADDRESS: Rt. 2, Box 341

LOCATION OF WELL: Owner's No. 9  
CITY AND STATE: Albany, Oregon

SE 1/4 SE 1/4 Sec. 6 T. 10 S. R. 3 W., W.M.

Bearing and distance from section or subdivision  
corner S. 27° 03' E. 27.32 chs. from NW cor.

Samuel T. Jones. DLC. 73

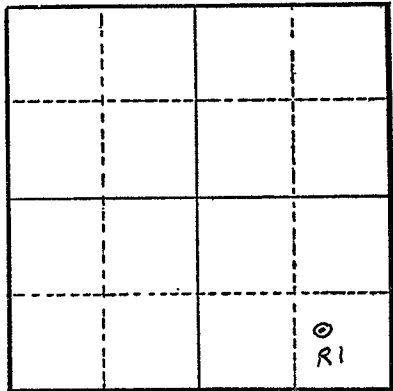

Section 6

Altitude at well 185 ft. Interpolated

TYPE OF WELL: drilled Date Constructed 6/12/47

Depth drilled 29 ft. Depth cased 29 ft.

CASING RECORD: 8 - inch steel casing set from 0 to 29 ft.

FINISH: slots from 23 to 29 ft.

AQUIFERS: unknown

WATER LEVEL: 8 ft. below land surface

PUMPING EQUIPMENT: Type Allis Chalmers 3" centrifugal H.P. 15  
Capacity 350 G.P.M.

WELL TESTS:

Drawdown	5	ft. after	.....	hours	.....	pumping	400	G.P.M.
Drawdown	.....	ft. after	.....	hours	.....			G.P.M.

USE OF WATER irrigation 40.5 acres Temp. °F. ...., 19

SOURCE OF INFORMATION Reg. St. GR-317

DRILLER or DIGGER Bill Hamilton; Albany, Oregon

ADDITIONAL DATA:  
Log ..... Water Level Measurements ..... Chemical Analysis ..... Aquifer Test .....

REMARKS: