

STATE ENGINEER
Salem, Oregon

LINN
4546

Well Record

STATE WELL NO. 10/3W-5Q
COUNTY Linn
APPLICATION NO. GR-833

OWNER: Walter L. Harnisch

MAILING
ADDRESS:

Rt. 2, Box 390

LOCATION OF WELL: Owner's No. 1

CITY AND
STATE:

Albany, Oregon

SW ¼ SE ¼ Sec. 5 T. 10 N. S. R. 3 E. W., W.M.

Bearing and distance from section or subdivision


corner N. 83° W. 32.25 chs. from SE cor. Sec. 5

Altitude at well 190 ft.

TYPE OF WELL: drilled Date Constructed 6/44

Depth drilled 24 ft. Depth cased 24 ft.

CASING RECORD: 8" steel 0 to 24 ft.

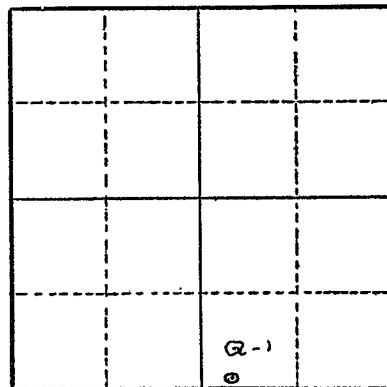

Section 5

FINISH: slot perforations from 14 to 24 ft.

AQUIFERS:

WATER LEVEL: 9 ft.

PUMPING EQUIPMENT: Type Fairbanks Morse 2" centrifugal H.P. 10 elec.
Capacity 260 G.P.M.

WELL TESTS:
Drawdown 2 ft. after hours 100 (est.) G.P.M.
Drawdown ft. after hours G.P.M.

USE OF WATER irrigation Temp. °F. 19

SOURCE OF INFORMATION

DRILLER or DIGGER Bill Hamilton Drilling Co.

ADDITIONAL DATA:

Log Water Level Measurements Chemical Analysis Aquifer Test

REMARKS: