

STATE ENGINEER
Salem, Oregon

LINN
4547

Well Record

STATE WELL NO. 10/3W-5R(1)
COUNTY Linn
APPLICATION NO. GR-835

OWNER: Walter L. Harnisch
MAILING ADDRESS: Rt. 2, Box 390

LOCATION OF WELL: Owner's No. 3
CITY AND STATE: Albany, Oregon

SE $\frac{1}{4}$ SE $\frac{1}{4}$ Sec. 5 T. 10 S. R. 3 W., W.M.


Bearing and distance from section or subdivision

corner N. 51° W. 17.25 chs. from SE cor. Sec. 5

Altitude at well 190 ft.

TYPE OF WELL: driven Date Constructed May 1937

Depth drilled 27 ft. Depth cased

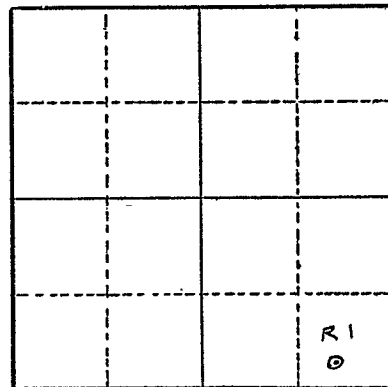

Section 5

CASING RECORD: 4" steel from 0 to 27 ft.

FINISH: Slot perforations from 18 to 27 ft.

AQUIFERS: 18 to 27 ft.

WATER LEVEL: 9 ft.

PUMPING EQUIPMENT: Type Cornell 3" centrifugal H.P. 15 elec.
Capacity 360 G.P.M.

WELL TESTS:
Drawdown 6 ft. after hours 400 G.P.M.
Drawdown ft. after hours G.P.M.

USE OF WATER irrigation Temp. °F. 19

SOURCE OF INFORMATION owner
DRILLER or DIGGER Walter R. Harnisch

ADDITIONAL DATA:
Log Water Level Measurements Chemical Analysis Aquifer Test

REMARKS: