

STATE ENGINEER
Salem, Oregon

Well Record

STATE WELL NO. 10/3W-5R(2)
COUNTY Linn
APPLICATION NO. GR- 922

GR- 895

OWNER: Henry Harnisch

MAILING

ADDRESS: 1320 S. Walnut

LOCATION OF WELL: Owner's No. #4

CITY AND

STATE: Albany, Oregon

SE $\frac{1}{4}$ SE $\frac{1}{4}$ Sec. 5 T. 10 S., R. 3 W., W.M.

Bearing and distance from section or subdivision

corner N70°15'W. 5.75 ch. from SE cor. Sec. 5.


Altitude at well 190 ft.

TYPE OF WELL: Driven Date Constructed 1938

Depth drilled 23 ft. Depth cased 23 ft.

CASING RECORD:

4 inch

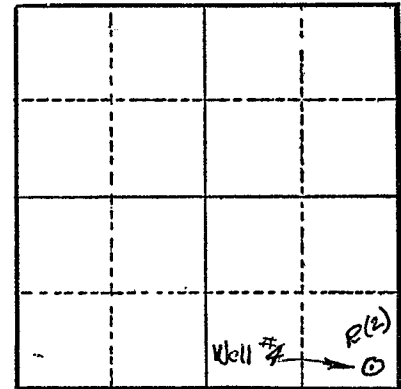

Section 5

FINISH:

Slot perforations from 10 to 23 ft.

AQUIFERS:

WATER LEVEL:

12 ft.

PUMPING EQUIPMENT: Type Pacific 2" Cent. H.P. 10

Capacity 250 G.P.M.

WELL TESTS:

Drawdown 5 ft. after 250 hours G.P.M.

Drawdown 5 ft. after 250 hours G.P.M.

USE OF WATER Irrigation Temp. 19 °F.

SOURCE OF INFORMATION G.R. Record

DRILLER or DIGGER Harnisch Bros.

ADDITIONAL DATA:

Log N.A. Water Level Measurements Chemical Analysis Aquifer Test

REMARKS:

Irrigation of 10.7 acres.