

STATE ENGINEER
Salem, Oregon

LINN
4559

LINN 4559

Well Record


STATE WELL NO. 10/3W-6A(1)
COUNTY Linn
APPLICATION NO. GR-202

OWNER: Chester F. & Hazel M. Royer MAILING ADDRESS: _____

LOCATION OF WELL: Owner's No. 1 CITY AND STATE: _____

NE 1/4 NE 1/4 Sec. 6 T. 10 N. S., R. 3 E. W., W.M.

Bearing and distance from section or subdivision corner N. 10° E. 43.75 chs. from NW cor. of Samuel T. Jones DLC 73

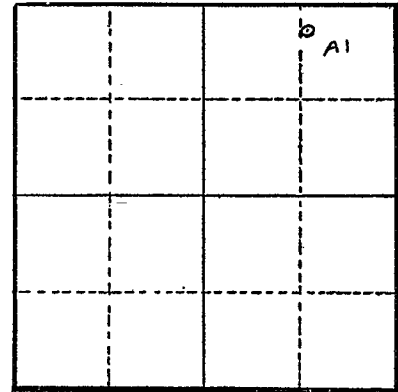

Section 6

Altitude at well 185 ft.

TYPE OF WELL: drilled Date Constructed 1947

Depth drilled 22 ft. Depth cased 22 ft.

CASING RECORD: 10 inch

FINISH:

AQUIFERS:

WATER LEVEL:

PUMPING EQUIPMENT: Type Fairbanks Morse 2" centrifugal H.P. 10
Capacity 250 G.P.M.

WELL TESTS:

Drawdown _____ ft. after _____ hours _____ G.P.M.

Drawdown _____ ft. after _____ hours _____ G.P.M.

USE OF WATER irrigation 17.3 acres Temp. _____ °F., 19

SOURCE OF INFORMATION _____

DRILLER or DIGGER _____

ADDITIONAL DATA:

Log _____ Water Level Measurements _____ Chemical Analysis _____ Aquifer Test _____

REMARKS:



Oregon Water Resources Department
 725 Summer Street NE, Suite A
 Salem Oregon 97301
 (503) 986-0900
 www.wrd.state.or.us

Application for Well ID Number

RECEIVED BY OWRD

Do not complete if the well already has a Well Identification Number.

DEC 15 2017

I. OWNER INFORMATION

SALEM, OR

Current Owner Name (please print): Douglas and Kari Burton
 Mailing Address: 32619 Cooper Dr. NE
 City, State, Zip: Albany, OR 97321
 Mail Well ID Tag to: SAME AS ABOVE In Care Of (C/O)
 Name & Address: _____
 City, State, Zip: _____

II. WELL LOCATION INFORMATION (Please fill out as completely as possible)

Township: 10S (North / South) Range: 3W (East / West) Section: 6 NE 1/4 of the NE 1/4
 Tax Lot (usually last 3-5 numbers of Tax Map #): 200 County Linn
 GPS Coordinates: _____
 Street Address of Well, City: 32619 Cooper Dr. NE, Albany OR
 If the property had a different street address in the past: _____

III. GENERAL WELL INFORMATION (Please fill out as completely as possible, AND attach copy of Well Log, if available)

Use of Well (domestic, irrigation, commercial, industrial, monitoring): Irrigation
 Date Well Constructed (or property built): 1947 Total Well Depth: 22 Casing Diameter: 10"
 Owner at time the well was constructed (if known): Royer Well Log # (if known): GR-202
 Other Information: ↳ Linn 4559

SUBMITTED BY (please print): Doug Burton Po B 165 Albany 97321
 PHONE: 541-791-8758 EMAIL &/or FAX: doug@blueberrymile.com

Send application to: Oregon Water Resources Department 725 Summer St NE, Suite A, Salem, Oregon 97301; or fax to (503) 986-0902.
 Applications are processed in the order they are received, and Well ID Numbers are mailed within 4-5 business days.

For Official Use Only by the Oregon Water Resources Department:

Received Date: <u>12-15-17</u>	Well Log Number: <u>LINN 4559</u>	Well Identification #: <u>L-128644</u>
-----------------------------------	--------------------------------------	---