

STATE ENGINEER
Salem, Oregon

LINN
4561

Well Record

STATE WELL NO. 10/3W-6B
COUNTY Linn
APPLICATION NO. GR-3028

OWNER: Howard J. and Doris E. Snodgrass


MAILING ADDRESS: Route 2, box 355

LOCATION OF WELL: Owner's No. #2

CITY AND STATE: Albany, Oregon

NW 1/4 NE 1/4 Sec. 6 T. 10 S., R. 3 W., W.M.

Bearing and distance from section or subdivision corner N. 49° 50' W. 38 chains from S. E. corner of NE 1/4

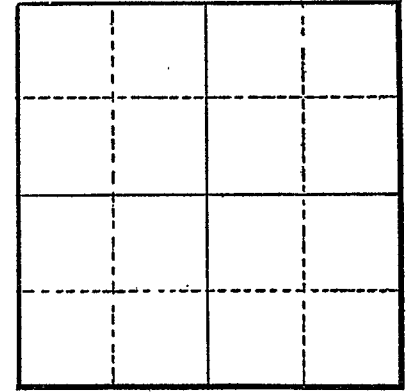

Section

Altitude at well

TYPE OF WELL: drilled Date Constructed 1943

Depth drilled 28 Depth cased 28

CASING RECORD:

8 inches from 0 to 28

FINISH:

AQUIFERS:

WATER LEVEL:

PUMPING EQUIPMENT: Type Fairbanks Morse Centrifugal H.P. 16
Capacity G.P.M.

WELL TESTS:

Drawdown ft. after hours G.P.M.
Drawdown ft. after hours G.P.M.

USE OF WATER Irrigation Temp. °F., 19

SOURCE OF INFORMATION GR-2836

DRILLER or DIGGER

ADDITIONAL DATA:

Log Water Level Measurements Chemical Analysis Aquifer Test

REMARKS: