

STATE ENGINEER
Salem, Oregon

LINN
4562

Well Record

STATE WELL NO. 10/3W-6B
COUNTY Linn
APPLICATION NO. GR-3029

OWNER: Howard J. and Doris E. Snodgrass


MAILING ADDRESS: Route 2, Box 355

LOCATION OF WELL: Owner's No. #3

CITY AND STATE: Albany, Oregon

NW 1/4 NE 1/4 Sec. 6, T. 10 S., R. 3 W., W.M.

Bearing and distance from section or subdivision corner N. 35° 50' W. 53.3 chains from S. corner of NE 1/4

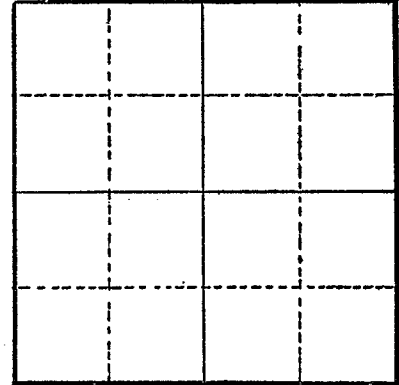

Section

Altitude at well

TYPE OF WELL: drilled Date Constructed 1945

Depth drilled 24 Depth cased 24

CASING RECORD:

10 inches

FINISH:

Slot perforations, from 14 to 24

AQUIFERS:

WATER LEVEL:

9 feet

PUMPING EQUIPMENT: Type Carver with G.E. motor H.P. 20
Capacity 400 G.P.M.

WELL TESTS:

Drawdown ft. after hours G.P.M.
Drawdown ft. after hours G.P.M.

USE OF WATER Irrigation Temp. °F., 19

SOURCE OF INFORMATION GR-2837

DRILLER or DIGGER Mr. Wymore, Salem, Oregon

ADDITIONAL DATA:

Log Water Level Measurements Chemical Analysis Aquifer Test

REMARKS: