

STATE ENGINEER
Salem, Oregon

LINN
4563


Well Record

STATE WELL NO. 10/3W-6F
COUNTY Linn
APPLICATION NO. GR-3030

OWNER: Howard J. and Doris E. Snodgrass MAILING ADDRESS: Route 2, Box 355

LOCATION OF WELL: Owner's No. 5 CITY AND STATE: Albany, Oregon

SE 1/4 NW 1/4 Sec. 6 T. 10 S., R. 3 W., W.M.
Bearing and distance from section or subdivision
corner N. 75° 30' W. 45 chains from S.E.
corner of NE 1/4

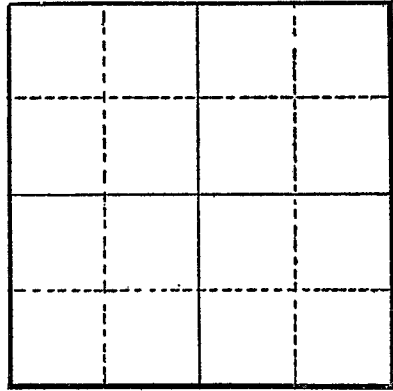

Section

Altitude at well

TYPE OF WELL: drilled Date Constructed 1944

Depth drilled 26 Depth cased 26

CASING RECORD:

10 inches

FINISH:

Slot perforations from 16 to 26

AQUIFERS:

WATER LEVEL:

PUMPING EQUIPMENT: Type Pacific with G.E. motor H.P. 15
Capacity 300 G.P.M.

WELL TESTS:
Drawdown ft. after hours G.P.M.
Drawdown ft. after hours G.P.M.

USE OF WATER Irrigation Temp. °F., 19

SOURCE OF INFORMATION GR-2838
DRILLER or DIGGER Mr. Wymore, Salem, Oregon

ADDITIONAL DATA:
Log Water Level Measurements Chemical Analysis Aquifer Test

REMARKS: