

STATE ENGINEER
Salem, Oregon

LINN
4581


Well Record

STATE WELL NO. 10/3W-7B(2)
COUNTY Linn
APPLICATION NO. GR-317

OWNER: Elbert H. & Esther F. Chambers
MAILING ADDRESS: Rt. 2, Box 341

LOCATION OF WELL: Owner's No. 4
CITY AND STATE: Albany, Oregon

NW ¼ NE ¼ Sec. 7 T. 10 S., R. 3 W., W.M.
Bearing and distance from section or subdivision
corner S. 63° 10' W. 42 chs. from NE cor. Sec. 7

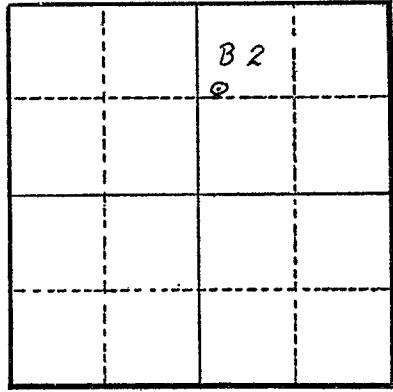

Altitude at well 185 ft. Interpolated

TYPE OF WELL: driven Date Constructed May 12, 1942

Depth drilled 30 ft. Depth cased 30 ft.

Section 7

CASING RECORD: 5 - inch steel casing (pipe) driven from 0 to 30 ft.

FINISH: Slots set from 25 to 30 ft.

AQUIFERS: unknown

WATER LEVEL: 13 ft. below land surface

PUMPING EQUIPMENT: Type Fairbanks Morse H.P. 7½
Capacity 175 G.P.M.

WELL TESTS:
Drawdown 4 ft. after _____ hours pumping 200 G.P.M.
Drawdown _____ ft. after _____ hours _____ G.P.M.

USE OF WATER irrigation 9.5 acres Temp. _____ °F. _____, 19____

SOURCE OF INFORMATION Reg. St. GR-317

DRILLER or DIGGER owner

ADDITIONAL DATA:
Log _____ Water Level Measurements _____ Chemical Analysis _____ Aquifer Test _____

REMARKS: