

STATE ENGINEER  
Salem, Oregon

LINA  
4583

# Well Record


STATE WELL NO. 10/3W-7C(1)  
COUNTY Linn  
APPLICATION NO. GR-317

OWNER: Elbert H. & Esther F. Chambers MAILING ADDRESS: Rt. 2, Box 341

LOCATION OF WELL: Owner's No. 1 CITY AND STATE: Albany, Oregon

NE 1/4 NW 1/4 Sec. 7 T. 10 S., R. 3 W., W.M.

Bearing and distance from section or subdivision  
corner N. 35° 40' E. 7.0 chs. from SE cor. John T.  
Crooks DLC 74

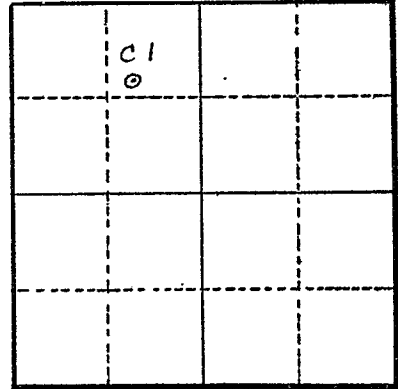

Section 7

Altitude at well 185 ft. Interpolated

TYPE OF WELL: drilled Date Constructed 5/10/47

Depth drilled 29 ft. Depth cased 29 ft.

CASING RECORD: 10 - inch casing set from 0 to 29 ft.

FINISH: Slit perforations set from 23 to 29 ft.

AQUIFERS: unknown

WATER LEVEL: 10 ft. below land surface

PUMPING EQUIPMENT: Type Fairbanks Morse 2" centrifugal H.P. 10  
Capacity 250 G.P.M.

WELL TESTS:  
Drawdown 5 ft. after \_\_\_\_\_ hours pumping 400 G.P.M.  
Drawdown \_\_\_\_\_ ft. after \_\_\_\_\_ hours \_\_\_\_\_ G.P.M.

USE OF WATER irrigation 19.2 acres Temp. \_\_\_\_\_ °F. \_\_\_\_\_, 19

SOURCE OF INFORMATION Reg. St. GR-317

DRILLER or DIGGER Bill Hamilton; 838 3rd Ave., Albany, Oregon

ADDITIONAL DATA:  
Log \_\_\_\_\_ Water Level Measurements \_\_\_\_\_ Chemical Analysis \_\_\_\_\_ Aquifer Test \_\_\_\_\_

REMARKS: