

LINN  
4584


# Well Record

OWNER: Elbert H. & Esther F. Chambers MAILING ADDRESS: Rt. 2, Box 341

LOCATION OF WELL: Owner's No. 2 CITY AND STATE: Albany, Oregon

NE 1/4 NW 1/4 Sec. 7 T. 10 S. R. 3 W., W.M.

Bearing and distance from section or subdivision corner S. 74° W. 43 chs. from NE cor. Sec. 7

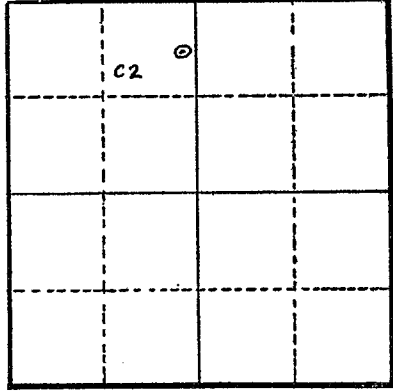

Section 7

Altitude at well 185 ft. Interpolated

TYPE OF WELL: driven Date Constructed 7/6/49

Depth drilled 24 ft. Depth cased 24 ft.

CASING RECORD: 5 - inch pipe driven to 24 ft.

FINISH: Slots between 19 and 24 ft. (dynamited by owner)

AQUIFERS: unknown

WATER LEVEL: 10 ft. below land surface

PUMPING EQUIPMENT: Type Gardner Denver 1 1/2" centrifugal H.P. 5  
Capacity 125 G.P.M.

WELL TESTS:  
Drawdown 5 ft. after \_\_\_\_\_ hours pumping 200 G.P.M.  
Drawdown \_\_\_\_\_ ft. after \_\_\_\_\_ hours \_\_\_\_\_ G.P.M.

USE OF WATER manufacturing (mint still) Temp. \_\_\_\_\_ °F. \_\_\_\_\_, 19

SOURCE OF INFORMATION Reg. St. GR-317

DRILLER or DIGGER owner

ADDITIONAL DATA:  
Log \_\_\_\_\_ Water Level Measurements \_\_\_\_\_ Chemical Analysis \_\_\_\_\_ Aquifer Test \_\_\_\_\_

REMARKS: