

STATE ENGINEER
Salem, Oregon

LINN
4585

Well Record

STATE WELL NO. 10/3W-7D(1)
COUNTY Linn
APPLICATION NO. GR- 1022

GR- 987

OWNER: D. L. Cook


MAILING ADDRESS: Rt. 2, Box 337

LOCATION OF WELL: Owner's No. #4

CITY AND STATE: Albany, Oregon

NW 1/4 NW 1/4 Sec. 7 T. 10 S., R. 3 W., W.M.

Bearing and distance from section or subdivision corner N38°W. 19.5 ch. from SE cor. DIC. #74.

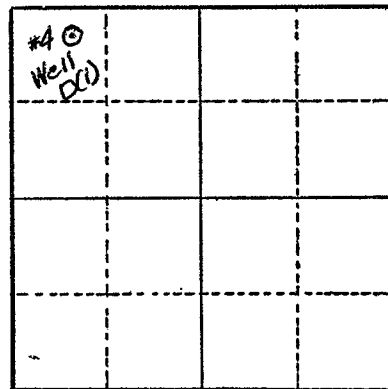

Altitude at well 180 ft.

TYPE OF WELL: Drilled Date Constructed 1953

Depth drilled 36 ft. Depth cased 36 ft.

Section 7

CASING RECORD:

10 inch

FINISH:

AQUIFERS:

WATER LEVEL:

10 ft.

PUMPING EQUIPMENT: Type 3" Cent. H.P. 15

Capacity 360 G.P.M.

WELL TESTS:

Drawdown 12 ft. after hours 400 G.P.M.

Drawdown ft. after hours G.P.M.

USE OF WATER Irrigation Temp. °F., 19

SOURCE OF INFORMATION G.R. Record

DRILLER or DIGGER Bill Hamilton Drilling Co.

ADDITIONAL DATA:

Log N.A. Water Level Measurements Chemical Analysis Aquifer Test

REMARKS:

Irrigation of 29.5 acres.