

STATE ENGINEER
Salem, Oregon

LINN
4586

Well Record

GR- 988

STATE WELL NO. 10/3W-7E(1)
COUNTY Linn
APPLICATION NO. GR-1023

OWNER: D. L. Cook

MAILING
ADDRESS:

Rt. 2, Box 337


LOCATION OF WELL: Owner's No. #5

CITY AND
STATE:

Albany, Oregon

SW 1/4 NW 1/4 Sec. 7 T. 10 S., R. 3 W., W.M.

Bearing and distance from section or subdivision
corner S72°W. 13 ch. from SE cor. D.C. #74

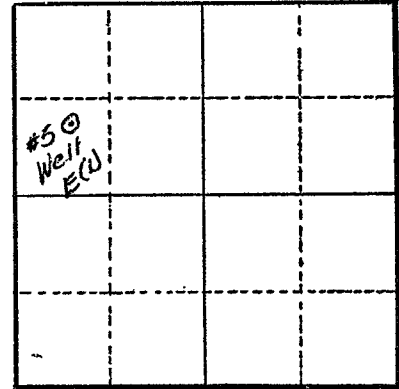

Section 7

Altitude at well 180 ft.

TYPE OF WELL: Drilled Date Constructed 1949

Depth drilled 36 ft. Depth cased 36 ft.

CASING RECORD:

10 inch

FINISH:

AQUIFERS:

WATER LEVEL:

12 ft.

PUMPING EQUIPMENT: Type 3" Cent. H.P. 15

Capacity 360 G.P.M.

WELL TESTS:

Drawdown _____ ft. after _____ hours _____ G.P.M.

Drawdown _____ ft. after _____ hours _____ G.P.M.

USE OF WATER Irrigation Temp. _____ °F. _____, 19____

SOURCE OF INFORMATION G.R. Record

DRILLER or DIGGER Bill Hamilton Drilling Co.

ADDITIONAL DATA:

Log N.A. Water Level Measurements _____ Chemical Analysis _____ Aquifer Test _____

REMARKS:

Irrigation of 50.7 acres.