

STATE ENGINEER
Salem, Oregon

LINN
4589

Well Record


STATE WELL NO. 10/3W-7H(1)
COUNTY Linn
APPLICATION NO. GR-317

OWNER: Elbert H. & Esther F. Chambers
MAILING ADDRESS: Rt. 2, Box 341

LOCATION OF WELL: Owner's No. 6
CITY AND STATE: Albany, Oregon

SE 1/4 NE 1/4 Sec. 7 T. 10 N. 3 E. W., W.M.

Bearing and distance from section or subdivision
corner S. 32° W. 24.52 chs. from NE cor. Sec. 7

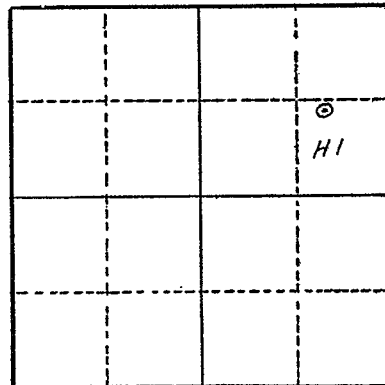

Section 7

Altitude at well 190 ft. Interpolated

TYPE OF WELL: drilled Date Constructed 7/7/49

Depth drilled 31 ft. Depth cased 31 ft.

CASING RECORD: 10 - inch steel casing set from 0 to 31 ft.

FINISH: Slit perforations from 25 to 31 ft.

AQUIFERS: unknown

WATER LEVEL: 14 ft. below land surface

PUMPING EQUIPMENT: Type Fairbanks Morse 3" centrifugal H.P. 15
Capacity 350 G.P.M.

WELL TESTS:
Drawdown 8 ft. after _____ hours pumping 400 G.P.M.
Drawdown _____ ft. after _____ hours _____ G.P.M.

USE OF WATER irrigation 49.2 acres Temp. _____ °F. _____, 19

SOURCE OF INFORMATION Reg. St. GR-317
DRILLER or DIGGER Bill Hamilton; Albany, Oregon

ADDITIONAL DATA:
Log _____ Water Level Measurements _____ Chemical Analysis _____ Aquifer Test _____

REMARKS: