

STATE ENGINEER
Salem, Oregon

Well Record

STATE WELL NO. 10/3W-8A(2)
COUNTY Linn
APPLICATION NO. GB-921

GR- 894

OWNER: Henry Harnisch

MAILING

ADDRESS: 1320 S. Walnut

LOCATION OF WELL: Owner's No. #3


CITY AND

STATE: Albany, Oregon

NE 1/4 NE 1/4 Sec. 8 T. 10 S. R. 3 W., W.M.

Bearing and distance from section or subdivision

corner S5°50'W. 17.5 ch. from NE cor. Sec. 8.

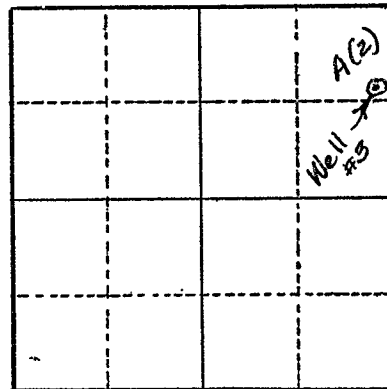

Altitude at well 194 ft.

TYPE OF WELL: Drilled Date Constructed 1945

Depth drilled 23 ft. Depth cased 23 ft.

Section 8

CASING RECORD:

6 inch

FINISH:

Slot perforations from 13 to 23 ft.

AQUIFERS:

WATER LEVEL:

12 ft.

PUMPING EQUIPMENT: Type 2" Cent. H.P. 5
Capacity 200 G.P.M.

WELL TESTS:

Drawdown 5 ft. after 250 hours G.P.M.

Drawdown ft. after hours G.P.M.

USE OF WATER Irrigation Temp. °F. 19

SOURCE OF INFORMATION G.R. Record

DRILLER or DIGGER Bill Hamilton Drilling Co.

ADDITIONAL DATA:

Log N.A. Water Level Measurements Chemical Analysis Aquifer Test

REMARKS:

Irrigation of 12.3 acres.