

STATE ENGINEER
Salem, Oregon

Well Record

STATE WELL NO. 10/3W-8B(1)
COUNTY Linn
APPLICATION NO. GR-919

GR- 892

OWNER: Henry Harnisch

MAILING

ADDRESS: 1320 S. Walnut

LOCATION OF WELL: Owner's No. #1


CITY AND

STATE: Albany, Oregon

NW 1/4 NE 1/4 Sec. 8 T. 10 S., R. 3 W., W.M.

Bearing and distance from section or subdivision

corner S63°15'W. 42.25 ch. from NE cor. Sec. 8.

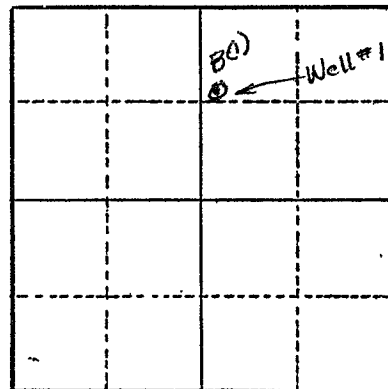

Section 8

Altitude at well 195 ft.

TYPE OF WELL: Drilled Date Constructed 1941

Depth drilled 23 ft. Depth cased 23 ft.

CASING RECORD:

8 inch

FINISH:

Slot perforations from 13 to 23 ft.

AQUIFERS:

WATER LEVEL:

12 ft.

PUMPING EQUIPMENT: Type F. M. 2" Cent. H.P. 10

Capacity 300 G.P.M.

WELL TESTS:

Drawdown 5 ft. after 400 hours G.P.M.

Drawdown ft. after hours G.P.M.

USE OF WATER Irrigation Temp. °F. 19

SOURCE OF INFORMATION G.R. Record

DRILLER or DIGGER Mr. Boyer

ADDITIONAL DATA:

Log N.A. Water Level Measurements Chemical Analysis Aquifer Test

REMARKS:

Irrigation of 11.5 acres.