

STATE ENGINEER
Salem, Oregon

LINN
4608

Well Record

STATE WELL NO. 10/3W-8C
COUNTY Linn
APPLICATION NO. GR-889

OWNER: Albert Harnisch

MAILING

ADDRESS: Rt. 2, Box 348

LOCATION OF WELL: Owner's No. 2


CITY AND

STATE: Albany, Oregon

NE $\frac{1}{4}$ NW $\frac{1}{4}$ Sec. 8 T. 10 S. R. 3 W., W.M.

Bearing and distance from section or subdivision

corner S. $63^{\circ} 20'$ W. 10.5 chs. from NE cor. NW $\frac{1}{4}$ Sec. 8

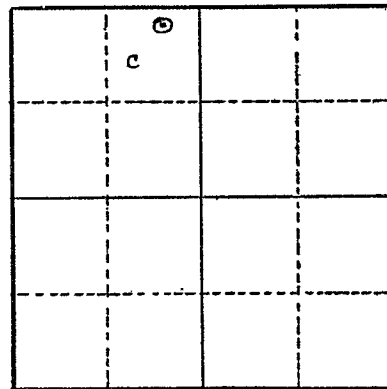

Section 8

Altitude at well 185 ft.

TYPE OF WELL: drilled Date Constructed May 1939

Depth drilled 25 ft. Depth cased 25 ft.

CASING RECORD: 8" steel from 0 to 25 ft.

FINISH: Slot perforations from 13 to 25 ft.

AQUIFERS:

WATER LEVEL: 14 ft. below land surface

PUMPING EQUIPMENT: Type Fairbanks Morse $2\frac{1}{2}$ " centrifugal H.P. 10 elec.
Capacity 250 G.P.M.

WELL TESTS:

Drawdown 5 ft. after hours 400 G.P.M.

Drawdown ft. after hours G.P.M.

USE OF WATER irrigation Temp. $^{\circ}$ F. 19

SOURCE OF INFORMATION owner

DRILLER or DIGGER Bill Hamilton

ADDITIONAL DATA:

Log Water Level Measurements Chemical Analysis Aquifer Test

REMARKS: