

STATE ENGINEER
Salem, Oregon

Well Record

STATE WELL NO. 10/3W-8C(2)
COUNTY Linn
APPLICATION NO. GR-890

OWNER: Albert Harnisch

MAILING
ADDRESS:

Rt. 2, Box 348

LOCATION OF WELL: Owner's No. 3


CITY AND
STATE:

Albany, Oregon

NE $\frac{1}{4}$ NW $\frac{1}{4}$ Sec. 8 T. 10 S. R. 3 W., W.M.

Bearing and distance from section or subdivision

corner S. 59° 40' W. 22 chs. from NE cor. NW $\frac{1}{4}$ Sec. 8

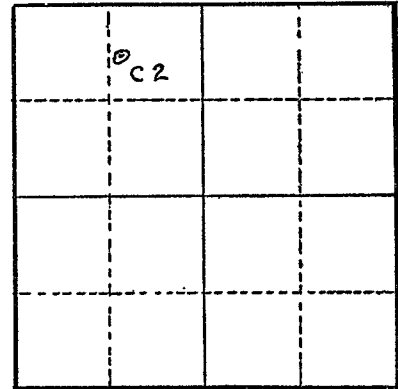

Altitude at well 185 ft.

TYPE OF WELL: drilled Date Constructed May 1948

Depth drilled 22 ft. Depth cased 22 ft.

Section 8

CASING RECORD: 6" steel from 0 to 22 ft.

FINISH: Slot perforations from 12 to 22 ft.

AQUIFERS:

WATER LEVEL: 13 ft. below land surface

PUMPING EQUIPMENT: Type Fairbanks Morse 2 $\frac{1}{2}$ " centrifugal H.P. 10 elec.
Capacity 250 G.P.M.

WELL TESTS:
Drawdown 8 ft. after _____ hours 280 G.P.M.
Drawdown _____ ft. after _____ hours _____ G.P.M.

USE OF WATER irrigation Temp. _____ °F. _____, 19____

SOURCE OF INFORMATION owner

DRILLER or DIGGER Cy Burkhardt, Tremonton, Utah

ADDITIONAL DATA:

Log _____ Water Level Measurements _____ Chemical Analysis _____ Aquifer Test _____

REMARKS: