

STATE ENGINEER
Salem, Oregon

LINN
4610

Well Record


STATE WELL NO. 10/3W-8D(1)
COUNTY Linn
APPLICATION NO. GR-317

OWNER: Elbert H. & Esther F. Chambers MAILING ADDRESS: Rt. 2, Box 341

LOCATION OF WELL: Owner's No. 7 CITY AND STATE: Albany, Oregon

NW 1/4 NW 1/4 Sec. 8 T. 10 N. S. R. 3 E. W., W.M.

Bearing and distance from section or subdivision corner S. 75° 46' E. 20.28 chs. from NW cor. Sec. 8

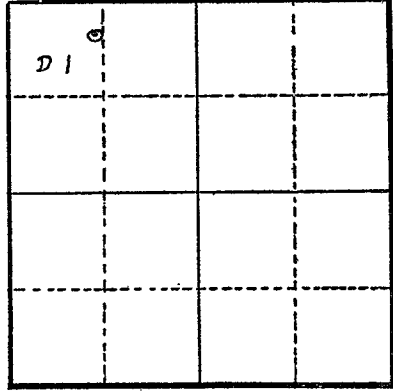

Altitude at well 190 ft. Interpolated

TYPE OF WELL: drilled Date Constructed 6/2/51

Depth drilled 21 ft. Depth cased 21 ft.

Section 8

CASING RECORD: 10 inch steel casing set from 0 to 21 ft.

FINISH: Slit perforations from 15 to 21 ft.

AQUIFERS: unknown

WATER LEVEL: 6 ft. below land surface

PUMPING EQUIPMENT: Type Fairbanks Morse 2" centrifugal H.P. 10
Capacity 225 G.P.M.

WELL TESTS:
Drawdown 3 ft. after _____ hours pumping 375 G.P.M.
Drawdown _____ ft. after _____ hours _____ G.P.M.

USE OF WATER irrigation 24.3 acres Temp. _____ °F. _____, 19

SOURCE OF INFORMATION Reg. St. GR-317
DRILLER or DIGGER Bill Hamilton; Albany, Oregon

ADDITIONAL DATA:
Log _____ Water Level Measurements _____ Chemical Analysis _____ Aquifer Test _____

REMARKS: