

STATE ENGINEER  
Salem, Oregon

LINN  
4611

# Well Record

STATE WELL NO. 10/3W-8F  
COUNTY LINN  
APPLICATION NO. GR-2960

OWNER: Charles LeRpy Jones


MAILING ADDRESS: R F D #2 Box 346

LOCATION OF WELL: Owner's No. #1

CITY AND STATE: Albany, Oregon

SE 1/4 NW 1/4 Sec. 8 T. 10 N. S., R. 3 E. W., W.M.

Bearing and distance from section or subdivision corner 2000' S. and 1650' E.

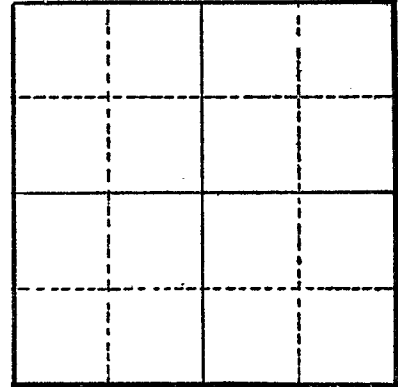

Section .....

Altitude at well

TYPE OF WELL: drilled Date Constructed 1948

Depth drilled 30 Depth cased 30

### CASING RECORD:

10-inch

### FINISH:

Perforated from 15 to 30

### AQUIFERS:

sand and gravel

### WATER LEVEL:

17-feet

PUMPING EQUIPMENT: Type Pacific Centrifugal H.P. 15  
Capacity 150 G.P.M.

### WELL TESTS:

Drawdown ..... ft. after ..... hours ..... G.P.M.  
Drawdown ..... ft. after ..... hours ..... G.P.M.

USE OF WATER Irrigation Temp. °F. 19

SOURCE OF INFORMATION GR-2777

DRILLER or DIGGER Jim Sneed

### ADDITIONAL DATA:

Log X Water Level Measurements Chemical Analysis Aquifer Test

### REMARKS:

Sand and gravel 0 30