

STATE ENGINEER
Salem, Oregon

LINN
4613

Well Record

STATE WELL NO. 10/3W - 8G
COUNTY LINN
APPLICATION NO. GR-2287

OWNER: M. C. Case


MAILING ADDRESS: Rt. 2, Box 393,

LOCATION OF WELL: Owner's No. No. 2

CITY AND STATE: Albany, Oregon

SW 1/4 NE 1/4 Sec. 8 T. 10 N. S. R. 3 W., W.M.

Bearing and distance from section or subdivision corner N. 75° 10' W. 39 chains from SE corner.

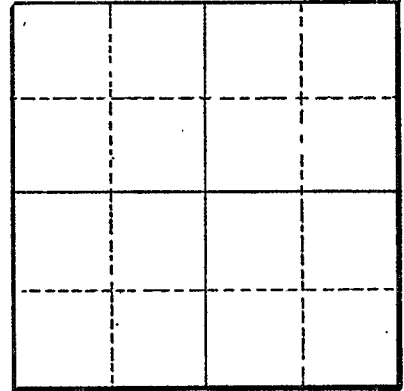

Section

Altitude at well

TYPE OF WELL: Drilled Date Constructed 1945

Depth drilled 22 Depth cased 22

CASING RECORD:

8-inch

FINISH:

Perforations from 15 to 22

AQUIFERS:

WATER LEVEL:

7-feet

PUMPING EQUIPMENT: Type Fairbanks Morse 3" Centrifugal H.P. 15
Capacity 350 G.P.M.

WELL TESTS:

Drawdown ft. after hours Pumping 400 G.P.M.
Drawdown ft. after hours G.P.M.

USE OF WATER Irrigation Temp. °F., 19

SOURCE OF INFORMATION GR-2180
DRILLER or DIGGER T. J. Burkhart, 1235 W. 15th., Albany, Oregon

ADDITIONAL DATA:

Log Water Level Measurements Chemical Analysis Aquifer Test

REMARKS: