

STATE ENGINEER  
Salem, Oregon

LINN  
4615

# Well Record

STATE WELL NO. 10/3W - 8G  
COUNTY LINN  
APPLICATION NO. GR-2289

OWNER: M. G. Case


MAILING ADDRESS: Rt. 2, Box 383

LOCATION OF WELL: Owner's No. #4

CITY AND STATE: Albany, Oregon

SW 1/4 NE 1/4 Sec. 8 T. 10 N. S., R. 3 E. W., W.M.

Bearing and distance from section or subdivision corner N. 68° 20' W. 26 chains.

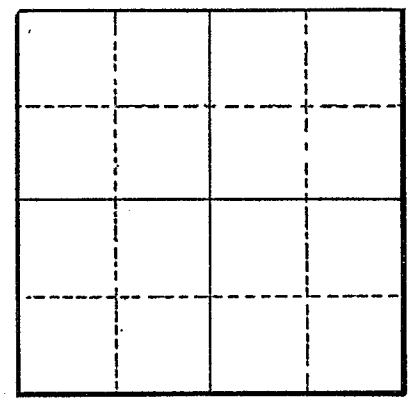

Section

Altitude at well

TYPE OF WELL: Drilled Date Constructed 1951

Depth drilled 22 Depth cased 22

### CASING RECORD:

8-inch

### FINISH:

Perforations from 14 to 22

### AQUIFERS:

### WATER LEVEL:

7-feet

PUMPING EQUIPMENT: Type Fairbanks Morse 2" Centrifugal H.P. 10  
Capacity 250 G.P.M.

### WELL TESTS:

Drawdown 5 ft. after hours Pumping 400 G.P.M.  
Drawdown ft. after hours G.P.M.

USE OF WATER Irrigation Temp. °F., 19

SOURCE OF INFORMATION GR-2184  
DRILLER or DIGGER Nicholas Klaus, Rt. 4, Albany, Oregon

### ADDITIONAL DATA:

Log Water Level Measurements Chemical Analysis Aquifer Test

### REMARKS: