

STATE ENGINEER
Salem, Oregon

LINN
4616

Well Record

STATE WELL NO. 10/3W - 8H
COUNTY LINN
APPLICATION NO. GR-2290

OWNER: M. C. Case


MAILING ADDRESS: Rt. 2, Box 393

LOCATION OF WELL: Owner's No. #5

CITY AND STATE: Albany, Oregon

SE 1/4 NE 1/4 Sec. 8 T. 10 N. S., R. 3 E. W., W.M.

Bearing and distance from section or subdivision corner N. 40° W. 25.25 chains

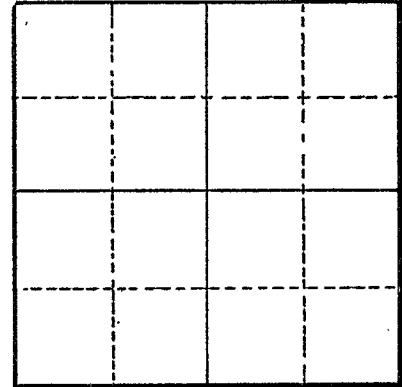

Section

Altitude at well

TYPE OF WELL: Drilled Date Constructed 1949

Depth drilled 24 Depth cased 24

CASING RECORD:

8-inch

FINISH:

Perforations from 14 to 24

AQUIFERS:

WATER LEVEL:

4-feet

PUMPING EQUIPMENT: Type Fairbanks Morse 2" Centrifugal H.P. 10
Capacity 250 G.P.M.

WELL TESTS:

Drawdown 5 ft. after hours Pumping 400 G.P.M.
Drawdown ft. after hours G.P.M.

USE OF WATER Irrigation Temp. °F., 19

SOURCE OF INFORMATION GR-2185

DRILLER or DIGGER

ADDITIONAL DATA:

Log Water Level Measurements Chemical Analysis Aquifer Test

REMARKS: