

STATE ENGINEER
Salem, Oregon

LINN
4617

Well Record

STATE WELL NO. 10/3W - 8H
COUNTY LINN
APPLICATION NO. GR-2291

OWNER: M. C. Case


MAILING ADDRESS: Rt. 2, Box 393

LOCATION OF WELL: Owner's No. #6

CITY AND STATE: Albany, Oregon

SE 1/4 NE 1/4 Sec. 8 T. 10 S. R. 3 W., W.M.

Bearing and distance from section or subdivision corner N. 65° 20' W. 11.75 chains.

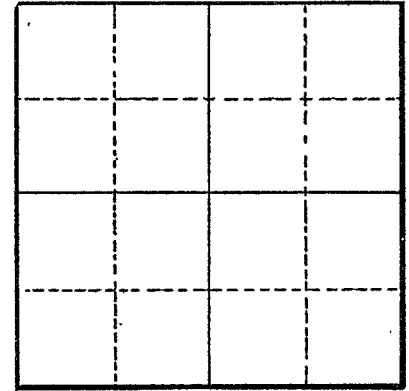

Section

Altitude at well

TYPE OF WELL: Driven Date Constructed 1935

Depth drilled 25 Depth cased 25

CASING RECORD:

4-inch

FINISH:

Perforations from 15 to 25

AQUIFERS:

WATER LEVEL:

7-feet

PUMPING EQUIPMENT: Type Fairbanks Morse 2" Centrifugal H.P. 10
Capacity 300 G.P.M.

WELL TESTS:

Drawdown 5 ft. after hours Pumping 400 G.P.M.
Drawdown ft. after hours G.P.M.

USE OF WATER Irrigation Temp. °F. 19

SOURCE OF INFORMATION GR-2186
DRILLER or DIGGER M. C. Case, Rt. 2, Box 393, Albany, Oregon

ADDITIONAL DATA:

Log Water Level Measurements Chemical Analysis Aquifer Test

REMARKS: