

STATE ENGINEER  
Salem, Oregon

LINN  
4619

# Well Record

STATE WELL NO. 10/3W - 8K  
COUNTY LINN  
APPLICATION NO. GR-2288

OWNER: M. C. Case


MAILING ADDRESS: Rt. 2, Box 393

LOCATION OF WELL: Owner's No. #3

CITY AND STATE: Albany, Oregon

NW 1/4 SE 1/4 Sec. 8 T. 10 N. 3 E. S. R. 3 W., W.M.

Bearing and distance from section or subdivision corner S. 81° 05' W. 38.25 chains.

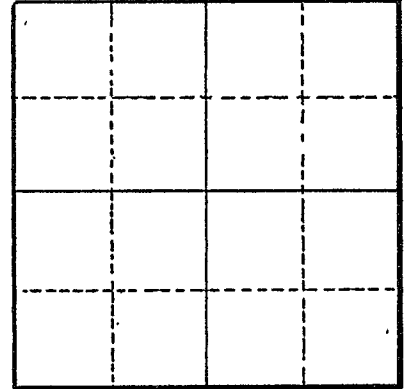

Section

Altitude at well

TYPE OF WELL: Driven Date Constructed 1941

Depth drilled 25 Depth cased 25

### CASING RECORD:

4-inch

### FINISH:

Perforations from 16 to 25

### AQUIFERS:

### WATER LEVEL:

9-feet

PUMPING EQUIPMENT: Type 3" Centrifugal H.P.  
Capacity 300 G.P.M.

### WELL TESTS:

Drawdown 10 ft. after hours Pumping 300 G.P.M.  
Drawdown ft. after hours G.P.M.

USE OF WATER Irrigation Temp. °F., 19

SOURCE OF INFORMATION GR-2183

DRILLER or DIGGER M. C. Case, Rt. 2, Box 393, Albany, Oregon

### ADDITIONAL DATA:

Log Water Level Measurements Chemical Analysis Aquifer Test

### REMARKS: