

STATE ENGINEER  
Salem, Oregon

LINN  
4620

# Well Record

STATE WELL NO. 10/3W-8L  
COUNTY LINN  
APPLICATION NO. GR-2961

OWNER: Charles LeRoy Jones


MAILING ADDRESS: R F D 2 Box 346

LOCATION OF WELL: Owner's No. #2

CITY AND STATE: Albany, Oregon

NE 1/4 SW 1/4 Sec. 8 T. 10 N. S., R. 3 W., W.M.

Bearing and distance from section or subdivision corner 950' W. and 25' S.

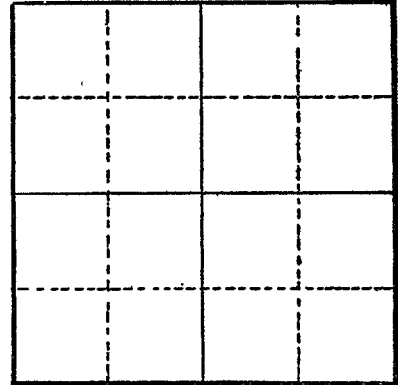

Section .....

Altitude at well .....

TYPE OF WELL: drilled Date Constructed 1955

Depth drilled 30 Depth cased 30

### CASING RECORD:

10-inch

### FINISH:

Perforated from 15 to 30

### AQUIFERS:

Sand and gravel

### WATER LEVEL:

17-feet

PUMPING EQUIPMENT: Type Pacific Centrifugal H.P. 15  
Capacity 230 G.P.M.

### WELL TESTS:

Drawdown ..... ft. after ..... hours ..... G.P.M.  
Drawdown ..... ft. after ..... hours ..... G.P.M.

USE OF WATER Irrigation Temp. °F. ...., 19

SOURCE OF INFORMATION GR-2778

### DRILLER or DIGGER

### ADDITIONAL DATA:

Log ..... Water Level Measurements ..... Chemical Analysis ..... Aquifer Test .....

### REMARKS:

Sand and Gravel 0 30