

STATE ENGINEER
Salem, Oregon

LINN
4640

Well Record


STATE WELL NO. 10/3W - 9A
COUNTY LINN
APPLICATION NO. GR-2211

OWNER: N. V. and Nellie Shelby
MAILING ADDRESS: Rt. 2, Box 483

LOCATION OF WELL: Owner's No. #1
CITY AND STATE: Albany, Oregon

NE 1/4 NE 1/4 Sec. 9 T. 10 N. S., R. 3 E. W., W.M.

Bearing and distance from section or subdivision
corner S. 60° 20' E. 25.1 chains

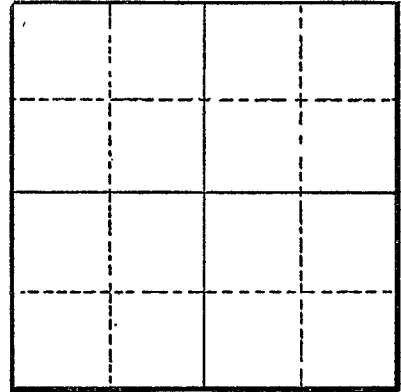

Section

Altitude at well

TYPE OF WELL: Drilled Date Constructed 1941

Depth drilled 21 Depth cased 21

CASING RECORD:

10-Inch

FINISH:

AQUIFERS:

WATER LEVEL:

13-Feet

PUMPING EQUIPMENT: Type Pacific 3" Centrifugal H.P. 15
Capacity 350 G.P.M.

WELL TESTS:

Drawdown ft. after hours G.P.M.
Drawdown ft. after hours G.P.M.

USE OF WATER Irrigation Temp. °F., 19

SOURCE OF INFORMATION GR-2116

DRILLER or DIGGER Marion West, Salem, Oregon

ADDITIONAL DATA:

Log Water Level Measurements Chemical Analysis Aquifer Test

REMARKS: