

STATE ENGINEER
Salem, Oregon

LINN
4643

Well Record

STATE WELL NO. 10/3W-9E
COUNTY Linn
APPLICATION NO. GR-927

OWNER: Cecil E. Cox


MAILING ADDRESS: Rt. 2, Box 397

LOCATION OF WELL: Owner's No.

CITY AND STATE: Albany, Oregon

SW 1/4 NW 1/4 Sec. 9 T. 10 S., R. 3 W., W.M.

Bearing and distance from section or subdivision corner S. 33° E. 36 chs. from NW cor. Sec. 9

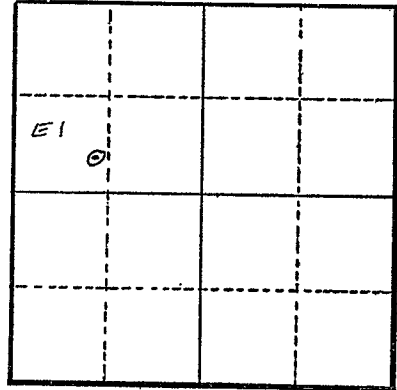

Section 9

Altitude at well 195 ft.

TYPE OF WELL: drilled Date Constructed May 1952

Depth drilled 26 ft. Depth cased 26 ft.

CASING RECORD: 6 in. steel from 0 to 26 ft.

FINISH: Slot perforations from 18 to 26 ft.

AQUIFERS:

WATER LEVEL: 12 ft.

PUMPING EQUIPMENT: Type Fairbanks Morse 2 1/2" centrifugal H.P. 10 elec.
Capacity 200 G.P.M.

WELL TESTS:

Drawdown	12	ft. after	hours	200	G.P.M.
Drawdown		ft. after	hours		G.P.M.

USE OF WATER irrigation Temp. °F. 19

SOURCE OF INFORMATION owner

DRILLER or DIGGER Nicholas Klaus; Rt. 4, Albany, Oregon

ADDITIONAL DATA:
Log Water Level Measurements Chemical Analysis Aquifer Test

REMARKS: