

STATE ENGINEER
Salem, Oregon

L1MAN
4646

Well Record

GR- 1756

STATE WELL NO. 10/3W-9G
COUNTY Linn
APPLICATION NO. GR- 1815

OWNER: Sidney Hess

MAILING

ADDRESS: Rt. 2, Box 398

LOCATION OF WELL: Owner's No. #2


CITY AND

STATE: Albany, Oregon

SW 1/4 NE 1/4 Sec. 9 T. 10 S., R. 3 W., W.M.

Bearing and distance from section or subdivision

corner 2442' S. & 2244' W. from NE cor. Sec. 9

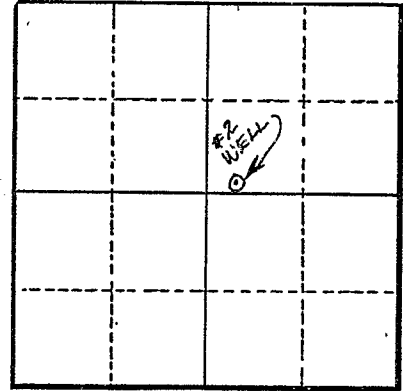

Section 9

Altitude at well 190'

TYPE OF WELL: Drilled. Date Constructed 1951

Depth drilled 20' Depth cased 20'

CASING RECORD:

8"

FINISH:

Slot perforated from 16 to 20 ft.

AQUIFERS:

WATER LEVEL:

9'

PUMPING EQUIPMENT: Type Pacific 2" Cent. H.P. 10
Capacity 400 G.P.M.

WELL TESTS:

Drawdown ft. after hours G.P.M.

Drawdown ft. after hours G.P.M.

USE OF WATER Irrigation Temp. °F. 19

SOURCE OF INFORMATION GR Record

DRILLER or DIGGER Bill Hamilton

ADDITIONAL DATA:

Log N.A. Water Level Measurements Chemical Analysis Aquifer Test

REMARKS:

Irrigation of 38.2 acres.