

STATE ENGINEER
Salem, Oregon

LINN
4647

Well Record

GR- 1755


STATE WELL NO. 10/3W-9L
COUNTY Linn
APPLICATION NO. GR- 1814

OWNER: Sidney Hess
MAILING ADDRESS: Rt. 2, Box 398

LOCATION OF WELL: Owner's No. #1
CITY AND STATE: Albany, Oregon

NE 1/4 SW 1/4 Sec. 9 T. 10 S., R. 3 W., W.M.

Bearing and distance from section or subdivision
corner 3168' S. & 3432' W. from NE cor. Sec. 9

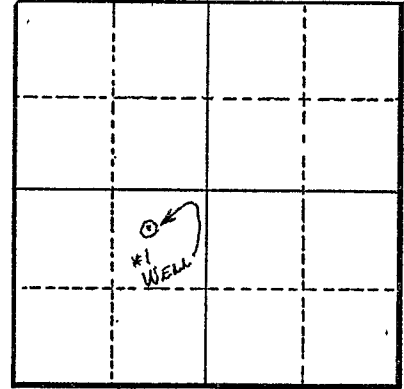

Section 9

Altitude at well 190'

TYPE OF WELL: Drilled Date Constructed 1949

Depth drilled 20' Depth cased 20'

CASING RECORD:

8"

FINISH:

Slot perforations from 14 to 20 ft.

AQUIFERS:

WATER LEVEL:

15'

PUMPING EQUIPMENT: Type Universal 2" Cent. H.P. 10

Capacity 300 G.P.M.

WELL TESTS:

Drawdown ft. after hours G.P.M.

Drawdown ft. after hours G.P.M.

USE OF WATER Irrigation Temp. °F. 19

SOURCE OF INFORMATION GR Record

DRILLER or DIGGER Bill Hamilton

ADDITIONAL DATA:

Log N.A. Water Level Measurements Chemical Analysis Aquifer Test

REMARKS:

Irrigation of 14 acres.