

LINN
4662

Well Record

STATE WELL NO. 10/3W-10H(1)
COUNTY Linn
APPLICATION NO. GR-136

OWNER: Leo A. Weddle

MAILING ADDRESS:


LOCATION OF WELL: Owner's No. 6

CITY AND STATE:

Jefferson, Oregon

SE 1/4 NE 1/4 Sec. 10 T. 10 S., R. 3 W., W.M.

Bearing and distance from section or subdivision corner 1450' S. & 550' W. from NE cor. Sec. 10

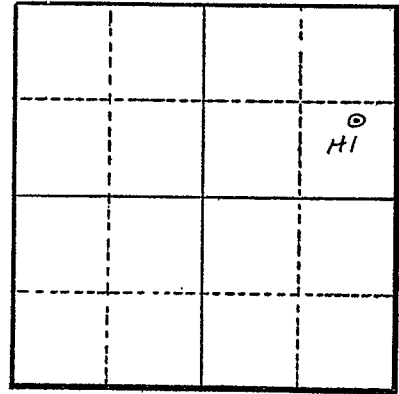

Section 10

Altitude at well 220 ft. Interpolated

TYPE OF WELL: dug Date Constructed May 1955

Depth drilled 15 ft. Depth cased 15 ft.

CASING RECORD: 10 - inch casing set from 0 to 15 ft.

FINISH: none

AQUIFERS: gravel from 6 to 15 ft.

WATER LEVEL: 4 ft. below land surface

PUMPING EQUIPMENT: Type Pacific centrifugal 4" x 3" G.E. H.P. 15
Capacity 420 G.P.M.

WELL TESTS:
Drawdown 2 ft. after 500 hours G.P.M.
Drawdown ft. after hours G.P.M.

USE OF WATER irrigation 50 acres Temp. °F. 19

SOURCE OF INFORMATION Reg. St. GR-136

DRILLER or DIGGER

ADDITIONAL DATA:

Log Water Level Measurements Chemical Analysis Aquifer Test

REMARKS: Log: Loam, silty 0 to 6 ft.
gravel, coarse 6 to 15 ft.