

STATE ENGINEER
Salem, Oregon

L I N N
4666

Well Record


STATE WELL NO. 10/3W-10J(1)
COUNTY Linn
APPLICATION NO. GR-695

OWNER: Howard J. & Pearl A. Miller MAILING ADDRESS: Rt. 2, Box 353

LOCATION OF WELL: Owner's No. 2 CITY AND STATE: Albany, Oregon

NE 1/4 SE 1/4 Sec. 10 T. 10 S., R. 3 W., W.M.

Bearing and distance from section or subdivision
corner S. 3° 30' W. 20.5 chs. from SE cor. Milton
Hale DLC 67

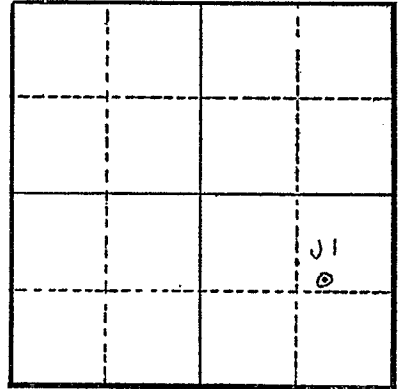

Section 10

Altitude at well 215 ft. Interpolated

TYPE OF WELL: drilled Date Constructed 5/11/51

Depth drilled 21 ft. Depth cased 21 ft.

CASING RECORD: 8 inch

FINISH:

AQUIFERS:

WATER LEVEL: 14 ft.

PUMPING EQUIPMENT: Type Berkeley centrifugal H.P. 18
Capacity 30 G.P.M.

WELL TESTS:
Drawdown 6 ft. after 300 hours G.P.M.
Drawdown ft. after hours G.P.M.

USE OF WATER irrigation Temp. °F. , 19

SOURCE OF INFORMATION GR-695

DRILLER or DIGGER Bill Hamilton, Albany, Oregon

ADDITIONAL DATA:
Log Water Level Measurements Chemical Analysis Aquifer Test

REMARKS: