

STATE ENGINEER  
Salem, Oregon

LINN  
4674

# Well Record

STATE WELL NO. 10/3W-11C(1)  
COUNTY Linn  
APPLICATION NO. GR-136

OWNER: Leo A. Weddle

MAILING  
ADDRESS:

LOCATION OF WELL: Owner's No. 5


CITY AND  
STATE:

Jefferson, Oregon

NE 1/4 NW 1/4 Sec. 11 T. 10 N. S. R. 3 W., W.M.

Bearing and distance from section or subdivision

corner 1625 ft. E. & 1090 ft. S. from NW cor. Sec. 11

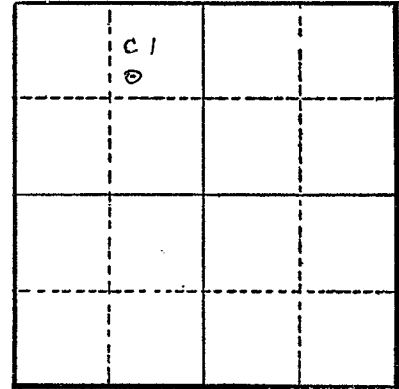

Section 11

Altitude at well 220 ft. Interpolated

TYPE OF WELL: drilled Date Constructed Oct. 1952

Depth drilled 20 ft. Depth cased 20 ft.

CASING RECORD: 10 inch casing set from 0 to 20 ft.

FINISH: none

AQUIFERS: gravel from 6 to 20 ft.

WATER LEVEL: 4 - 6 ft. below land surface

PUMPING EQUIPMENT: Type Allis Chalmers centrifugal 3-3" H.P. 15  
Capacity 330 G.P.M.

WELL TESTS:  
Drawdown 2 ft. after hours 550 G.P.M.  
Drawdown ft. after hours G.P.M.

USE OF WATER irrigation 40 acres Temp. °F. 19

SOURCE OF INFORMATION Reg. St. GR-136

DRILLER or DIGGER

ADDITIONAL DATA:

Log  Water Level Measurements Chemical Analysis Aquifer Test

REMARKS: Log: Loam, sandy 0 to 14 ft.  
Gravel, coarse 14 to 20 ft.