

STATE ENGINEER
Salem, Oregon

LINN
4675

Well Record

STATE WELL NO. 10/3W-11F(1)
COUNTY Linn
APPLICATION NO. GR-136

OWNER: Leo A. Weddle


MAILING ADDRESS:

LOCATION OF WELL: Owner's No. 1

CITY AND STATE: Jefferson, Oregon

SE 1/4 NW 1/4 Sec. 11 T. 10 N. S., R. 3 E. W., W.M.

Bearing and distance from section or subdivision corner 125' N. & 200' W. from center Sec. 11

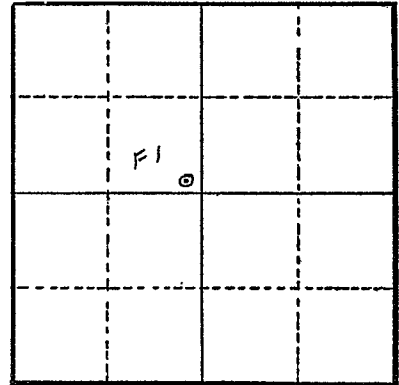

Section 11

Altitude at well 220 ft. Interpolated

TYPE OF WELL: drilled Date Constructed Feb. 1940

Depth drilled 20 ft. Depth cased 20 ft.

CASING RECORD: 10 - inch casing set from 0 to 20 ft.

FINISH: Perforations where?

AQUIFERS: Gravel from 11 to 20 ft.

WATER LEVEL: 8 to 10 ft. below land surface

PUMPING EQUIPMENT: Type Pacific centrifugal 4" x 3" H.P. 20
Capacity 650 G.P.M.

WELL TESTS:
Drawdown 4 ft. after hours 600 G.P.M.
Drawdown ft. after hours G.P.M.

USE OF WATER irrigation 45 acres Temp. °F. 19

SOURCE OF INFORMATION Reg. St. GR-136

DRILLER or DIGGER

ADDITIONAL DATA:

Log Water Level Measurements Chemical Analysis Aquifer Test

REMARKS: Log: Loam, sandy 0 to 9 ft.
Gravel med. to coarse 9 to 20 ft.