

STATE ENGINEER
Salem, Oregon

LINN
4676

Well Record

STATE WELL NO. 10/3W-11E(1)
COUNTY Linn
APPLICATION NO. GR-136

OWNER: Leo A. Weddle

MAILING
ADDRESS:


LOCATION OF WELL: Owner's No. 3

CITY AND
STATE:

Jefferson, Oregon

SW 1/4 NW 1/4 Sec. 11 T. 10 N. S., R. 3 E. W., W.M.

Bearing and distance from section or subdivision
corner 900' N. & 275' E. from W 1/4 cor. Sec. 11

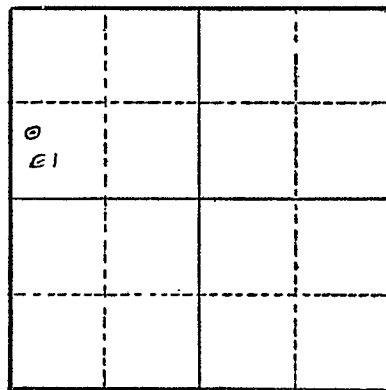

Section 11

Altitude at well 220 ft. Interpolated

TYPE OF WELL: drilled Date Constructed March 1941

Depth drilled 25 ft. Depth cased 25 ft.

CASING RECORD: 10 - inch casing set from 0 to 25 ft.

FINISH: none

AQUIFERS: gravel from 10 to 25 ft.

WATER LEVEL: 8 - 10 ft. below land surface

PUMPING EQUIPMENT: Type Allis Chalmers centrifugal 3 x 3 H.P. 15
Capacity 330 G.P.M.

WELL TESTS:
Drawdown 5 ft. after 450 hours G.P.M.
Drawdown ft. after hours G.P.M.

USE OF WATER irrigation 30 acres Temp. °F., 19

SOURCE OF INFORMATION Reg. St. GR-136

DRILLER or DIGGER

ADDITIONAL DATA:

Log Water Level Measurements Chemical Analysis Aquifer Test

REMARKS: Log: Loam, sandy 0 to 10 ft.
Gravel, coarse 10 to 25 ft.