

STATE ENGINEER
Salem, Oregon

LINN
4678

Well Record

STATE WELL NO. 10/3W-11G(1)
COUNTY Linn
APPLICATION NO. GR-136

OWNER: Leo A. Weddle

MAILING
ADDRESS: _____


LOCATION OF WELL: Owner's No. 2

CITY AND
STATE: _____

Jefferson, Oregon

SW 1/4 NE 1/4 Sec. 11 T. 10 S., R. 3 W., W.M.

Bearing and distance from section or subdivision
corner 140' E. & 850' N. from center Sec. 11

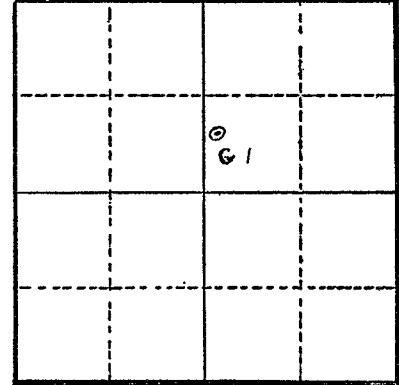

Section 11

Altitude at well 220 ft. Interpolated

TYPE OF WELL: drilled Date Constructed Mar. 1943

Depth drilled 20 ft. Depth cased 20 ft.

CASING RECORD: 10 - inch casing set from 0 to 20 ft.

FINISH: none

AQUIFERS: gravel from 10 to 20 ft.

WATER LEVEL: 8 - 10 ft. below land surface

PUMPING EQUIPMENT: Type Pacific centrifugal 3" x 4" H.P. 15
Capacity 350 G.P.M.

WELL TESTS:
Drawdown 6 ft. after _____ hours 400 G.P.M.
Drawdown _____ ft. after _____ hours _____ G.P.M.

USE OF WATER irrigation 27 acres Temp. _____ °F. _____, 19____

SOURCE OF INFORMATION Reg. St. GR-136

DRILLER or DIGGER _____

ADDITIONAL DATA:

Log Water Level Measurements _____ Chemical Analysis _____ Aquifer Test _____

REMARKS: Log: Loam, sandy 0 to 10 ft.
Gravel, coarse 10 to 20 ft.