

STATE ENGINEER  
Salem, Oregon

LINN  
4679

# Well Record

STATE WELL NO. 10/3W-11G(2)  
COUNTY Linn  
APPLICATION NO. GR-136

OWNER: Leo A. Weddle

MAILING ADDRESS:


LOCATION OF WELL: Owner's No. 4

CITY AND STATE:

Jefferson, Oregon

SW 1/4 NE 1/4 Sec. 11 T. 10 N. S. R. 3 W., W.M.

Bearing and distance from section or subdivision corner 250' N. & 650' E. from center Sec. 11

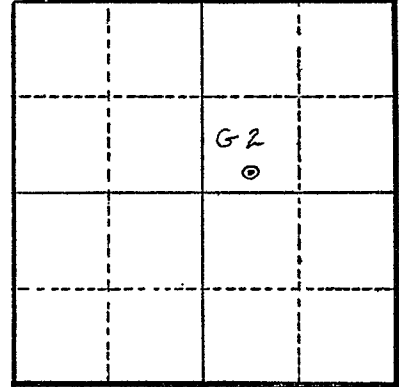

Section 11

Altitude at well 220 ft. Interpolated

TYPE OF WELL: drilled Date Constructed Apr. 1944

Depth drilled 20 ft. Depth cased 20 ft.

CASING RECORD: 10 - inch casing set from 0 to 20 ft.

FINISH: none

AQUIFERS: gravel from 6 to 20 ft.

WATER LEVEL: 8 1/2 ft. below land surface April 1944

PUMPING EQUIPMENT: Type \_\_\_\_\_ H.P. \_\_\_\_\_  
Capacity \_\_\_\_\_ G.P.M.

WELL TESTS:  
Drawdown 6 ft. after \_\_\_\_\_ hours 580 G.P.M.  
Drawdown \_\_\_\_\_ ft. after \_\_\_\_\_ hours \_\_\_\_\_ G.P.M.

USE OF WATER irrigation 40 acres Temp. \_\_\_\_\_ °F. \_\_\_\_\_, 19\_\_\_\_  
SOURCE OF INFORMATION Reg. St. GR-136

DRILLER or DIGGER \_\_\_\_\_

ADDITIONAL DATA:

Log  Water Level Measurements \_\_\_\_\_ Chemical Analysis \_\_\_\_\_ Aquifer Test \_\_\_\_\_

REMARKS: Log: Loam, sandy 0 to 6 ft.  
Gravel, coarse 6 to 20 ft.