

STATE ENGINEER
Salem, Oregon

LINN
4680

Well Record

STATE WELL NO. 10/3W-11K(1)
COUNTY Linn
APPLICATION NO. GR-299

OWNER: Rose M. Grenz


MAILING ADDRESS: Rt. 2, Box 428A

LOCATION OF WELL: Owner's No. 2

CITY AND STATE: Albany, Oregon

NW 1/4 SE 1/4 Sec. 11 T. 10 N. S. R. 3 W., W.M.

Bearing and distance from section or subdivision corner N. 23° E. 28 chs. from SW cor. SE 1/4 Sec. 11

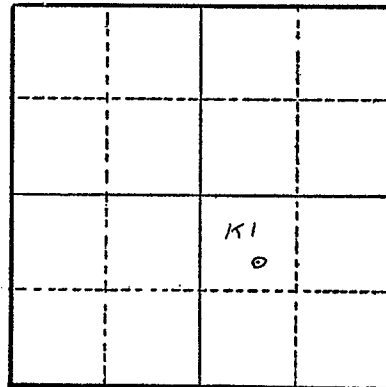

Section 11

Altitude at well 215 ft. Interpolated

TYPE OF WELL: drilled Date Constructed 4/12/53

Depth drilled 28 ft. Depth cased 28 ft.

CASING RECORD: 8 - inch steel casing set from 0 to 28 ft.

FINISH: Slit perforations set from 18 to 28 ft.

AQUIFERS: unknown

WATER LEVEL: 10 ft. below land surface

PUMPING EQUIPMENT: Type Berkeley 2" centrifugal H.P. 10
Capacity 300 G.P.M.

WELL TESTS:
Drawdown 4 ft. after _____ hours pumping 300 G.P.M.
Drawdown _____ ft. after _____ hours _____ G.P.M.

USE OF WATER irrigation 4 acres Temp. _____ °F. _____, 19____

SOURCE OF INFORMATION Reg. St. GR-299

DRILLER or DIGGER Wymore Drilling; Salem, Oregon

ADDITIONAL DATA:

Log _____ Water Level Measurements _____ Chemical Analysis _____ Aquifer Test _____

REMARKS: