

STATE ENGINEER
Salem, Oregon

LINN
4683

Well Record

STATE WELL NO. 10/3W-11M(1)
COUNTY Linn
APPLICATION NO. GR-694

OWNER: Howard J. & Pearl A. Miller


MAILING ADDRESS: Rt. 2, Box 353

LOCATION OF WELL: Owner's No. 1

CITY AND STATE: Albany, Oregon

NW 1/4 SW 1/4 Sec. 11 T. 10 N. S., R. 3 W., W.M.

Bearing and distance from section or subdivision corner S. 40° E. 23 chs. from SE cor. Milton Hale
DLC 67

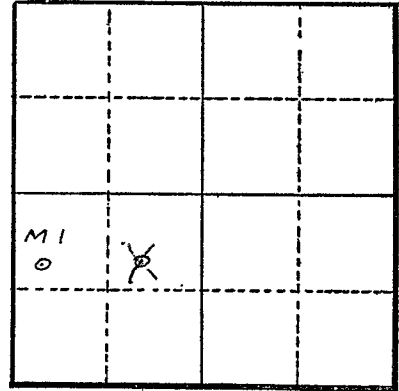

Section 11

Altitude at well 215 ft. Interpolated

TYPE OF WELL: drilled Date Constructed 5/1/51

Depth drilled 22 ft. Depth cased 22 ft.

CASING RECORD: 8 inch

FINISH:

AQUIFERS:

WATER LEVEL: 11 ft.

PUMPING EQUIPMENT: Type Berkeley centrifugal H.P. 15
Capacity 400 G.P.M.

WELL TESTS:

Drawdown 5 ft. after 500 hours G.P.M.

Drawdown ft. after hours G.P.M.

USE OF WATER irrigation 11.9 acres Temp. °F., 19

SOURCE OF INFORMATION GR-694

DRILLER or DIGGER Bill Hamilton; Albany, Oregon

ADDITIONAL DATA:

Log Water Level Measurements Chemical Analysis Aquifer Test

REMARKS: