

STATE ENGINEER  
Salem, Oregon

LINN  
4684

# Well Record

STATE WELL NO. 10/3W - 11N  
COUNTY LINN  
APPLICATION NO. GR-2285

OWNER: Agnes Hilliker


MAILING ADDRESS: Route 2, Box 424

LOCATION OF WELL: Owner's No.

CITY AND STATE: Albany, Oregon

SW 1/4 SW 1/4 Sec. 11 T. 10 N. S, R. 3 E. W., W.M.

Bearing and distance from section or subdivision corner N. 79° 20' E. 12 chains from SW corner.

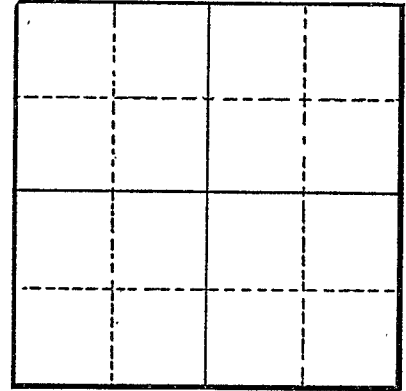

Section .....

Altitude at well

TYPE OF WELL: Drilled Date Constructed 1943

Depth drilled 25 Depth cased 25

### CASING RECORD:

4-inch

### FINISH:

Perforations from 15 to 25

### AQUIFERS:

### WATER LEVEL:

10-feet

PUMPING EQUIPMENT: Type 2 1/2" Centrifugal pump H.P.  
Capacity 200 G.P.M.

### WELL TESTS:

Drawdown ..... ft. after ..... hours ..... G.P.M.  
Drawdown ..... ft. after ..... hours ..... G.P.M.

USE OF WATER Irrigation Temp. °F. ...., 19

SOURCE OF INFORMATION GR-2178

DRILLER or DIGGER Nicholas Klaus, Route 4, Albany, Oregon

### ADDITIONAL DATA:

Log ..... Water Level Measurements ..... Chemical Analysis ..... Aquifer Test .....

### REMARKS: